


1201 MARYLAND AVENUE, SW

6TH LEVEL - UP TO 30,612 SF AS-BUILT PLAN



KEY PLAN

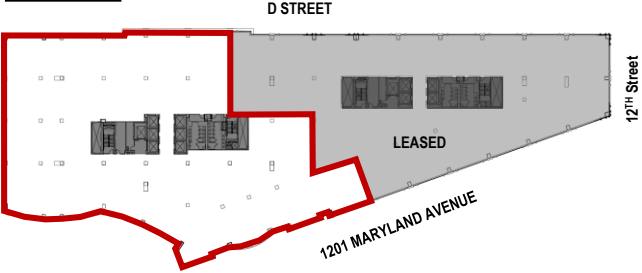

*Furniture is for marketing purposes only